



REGISTERED SURVEYOR'S CERTIFICATION


I, _____, hereby certify that the vertical and horizontal locations and dimensions shown on this plan are a true and correct record and were located by survey.

Registered Surveyor (sig.) Reg. Surveyor No. _____ Date: _____


ENGINEER'S CERTIFICATION

- I, _____, hereby certify that:
1. The information contained in this drawing / document is in compliance with approved drawings and design.
 2. The new water and sewerage works defined by this drawing have been designed and constructed in accordance with the SEQ Code.
 3. This represents an accurate record of as-constructed works
 4. I accept responsibility for the information contained in this drawing / document.

RPEQ (signature) RPEQ No. _____ Date: _____

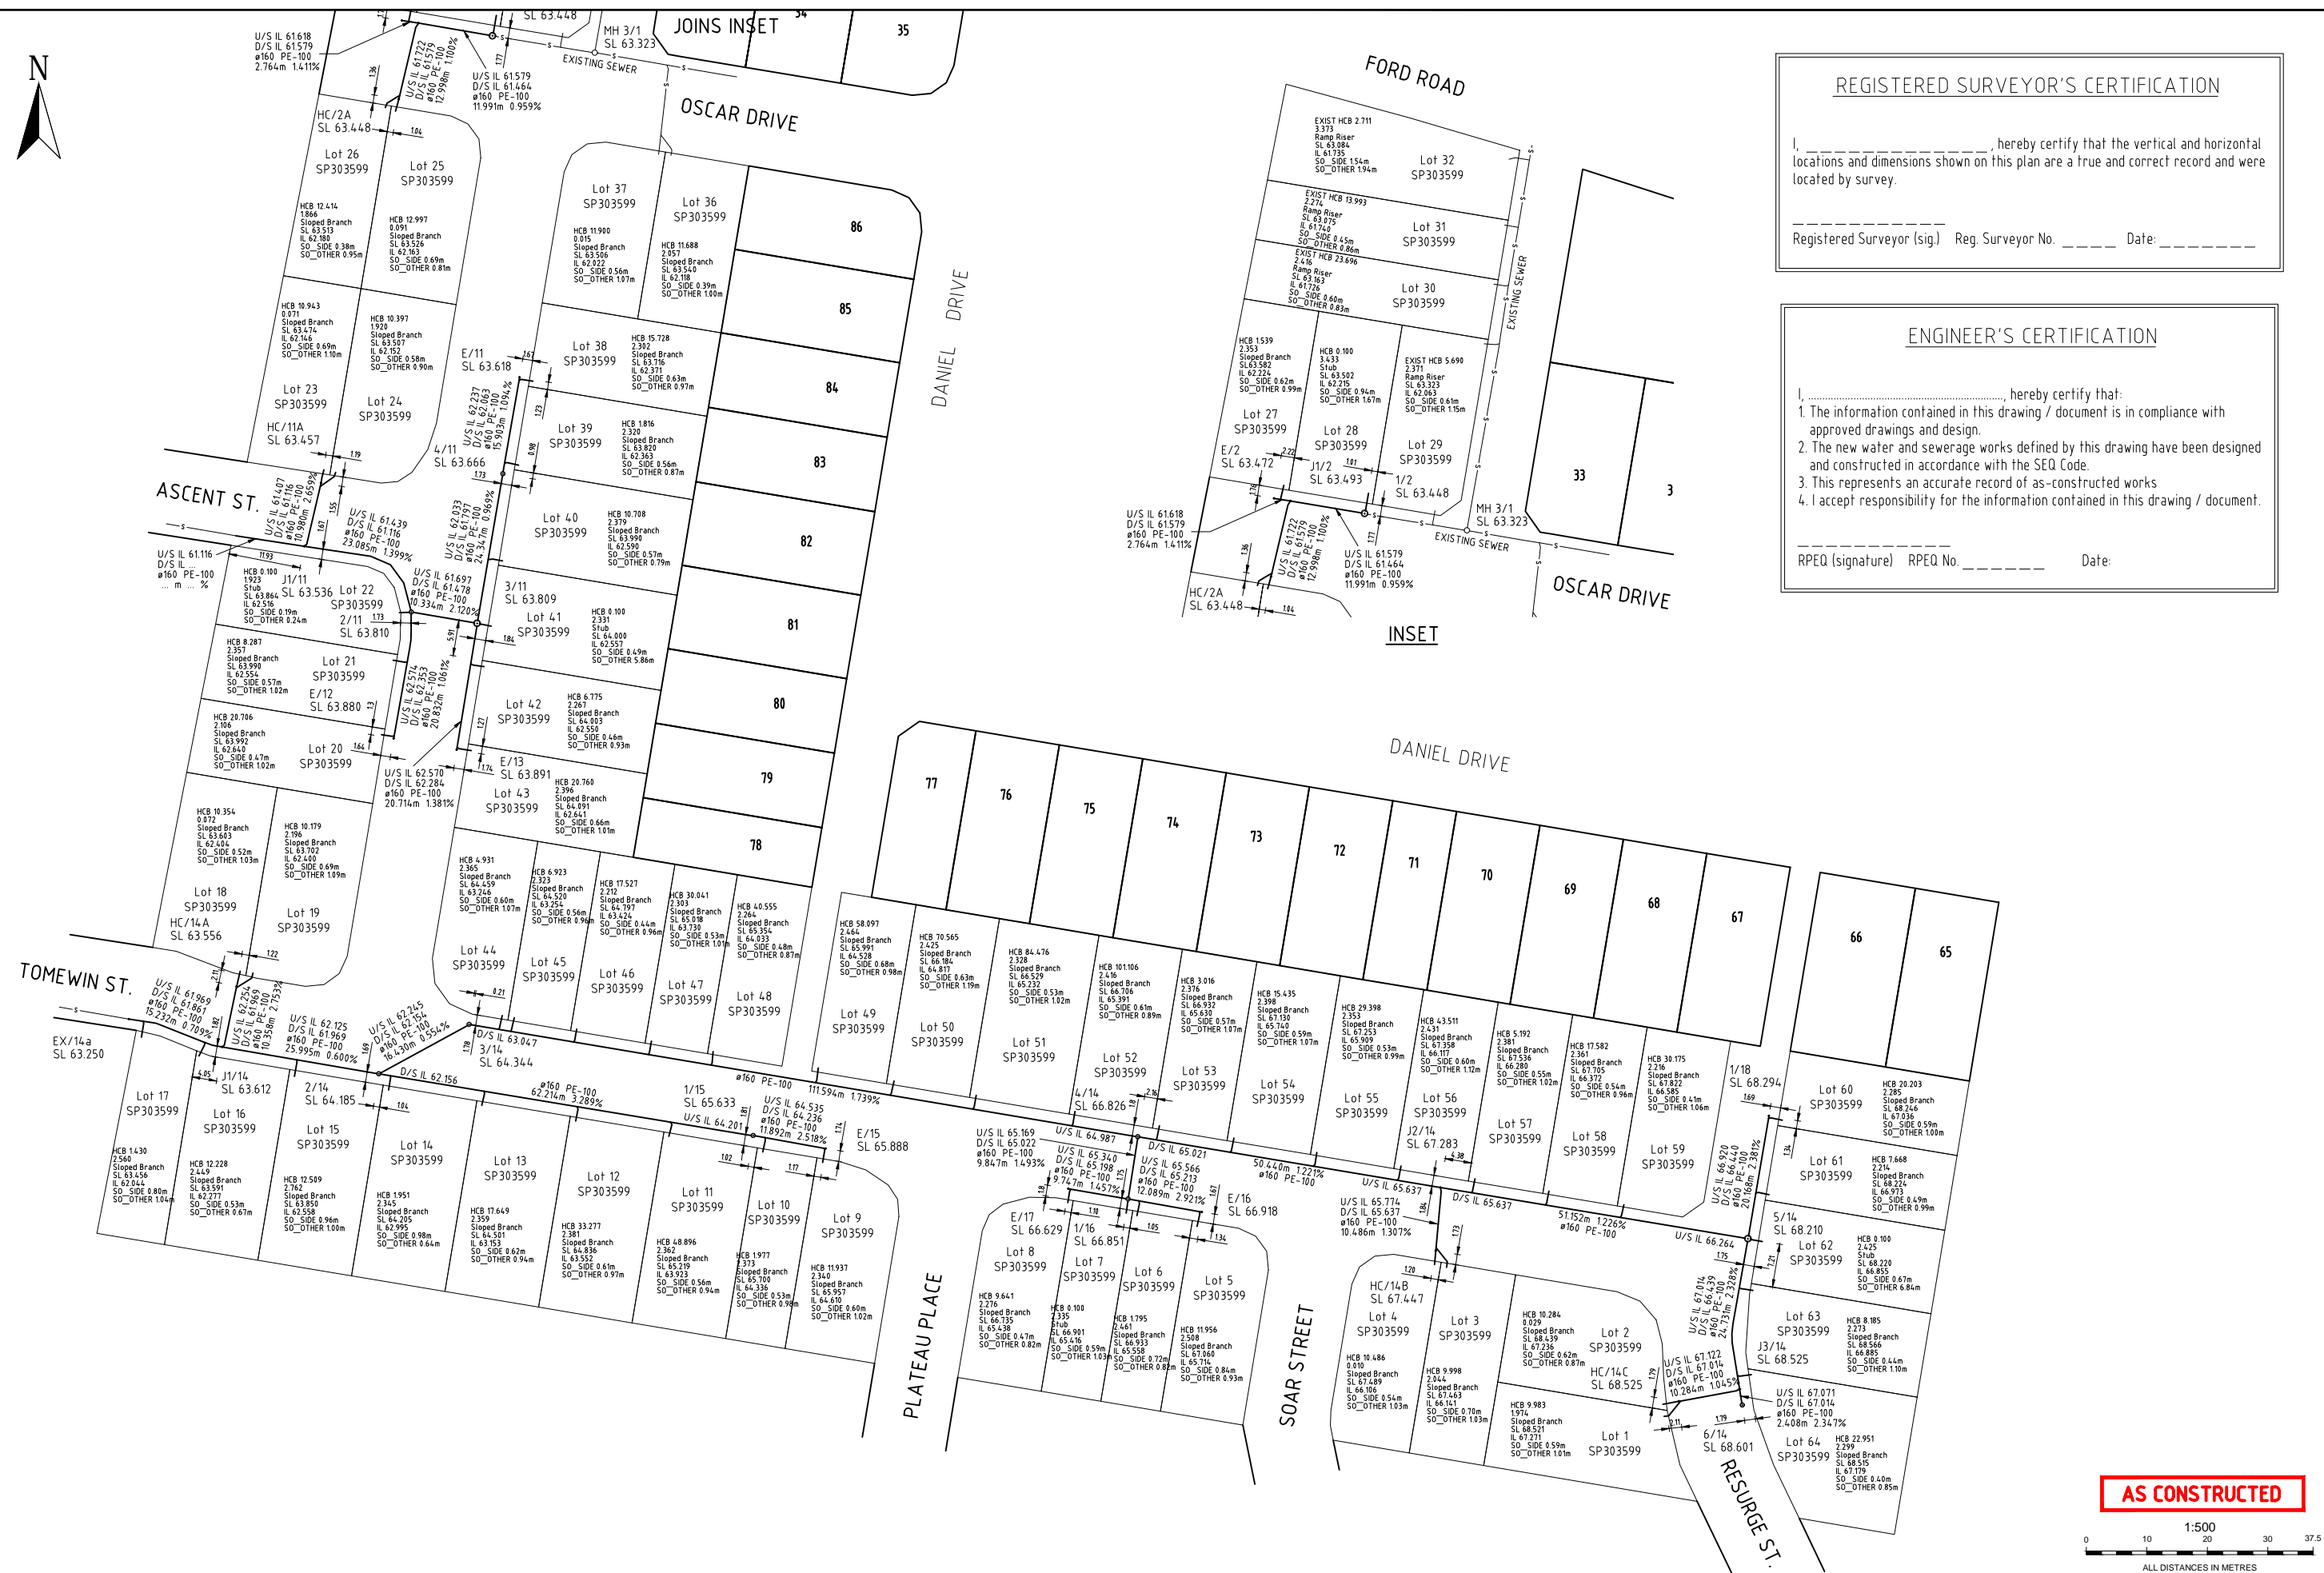

AS CONSTRUCTED

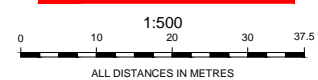

A1

INDEX	DATE	AS CONSTRUCTED	REVISIONS	DRAWN	CHECKED	PASSED
0	12/10/2018	AS CONSTRUCTED		GH		

DRAWN	GH
CHECKED	
PASSED	
INITIALS	DATE

SURVEY MANAGEMENT SOLUTIONS (QLD)

 1587 Ipswich Road,
 Rocklea, Qld. 4106
 Phone: (07) 3491 8995

QUEENSLAND UrbanUtilities

Queensland Urban Utilities
 272-284 GARDENER ROAD
 ROCHEDALE (STAGE 2)
 SEWER RETICULATION

SCALE	1:500
SHEET 1 OF 1 SHEETS	
DRAWING NO.	10785-S02